



Elevation A-A

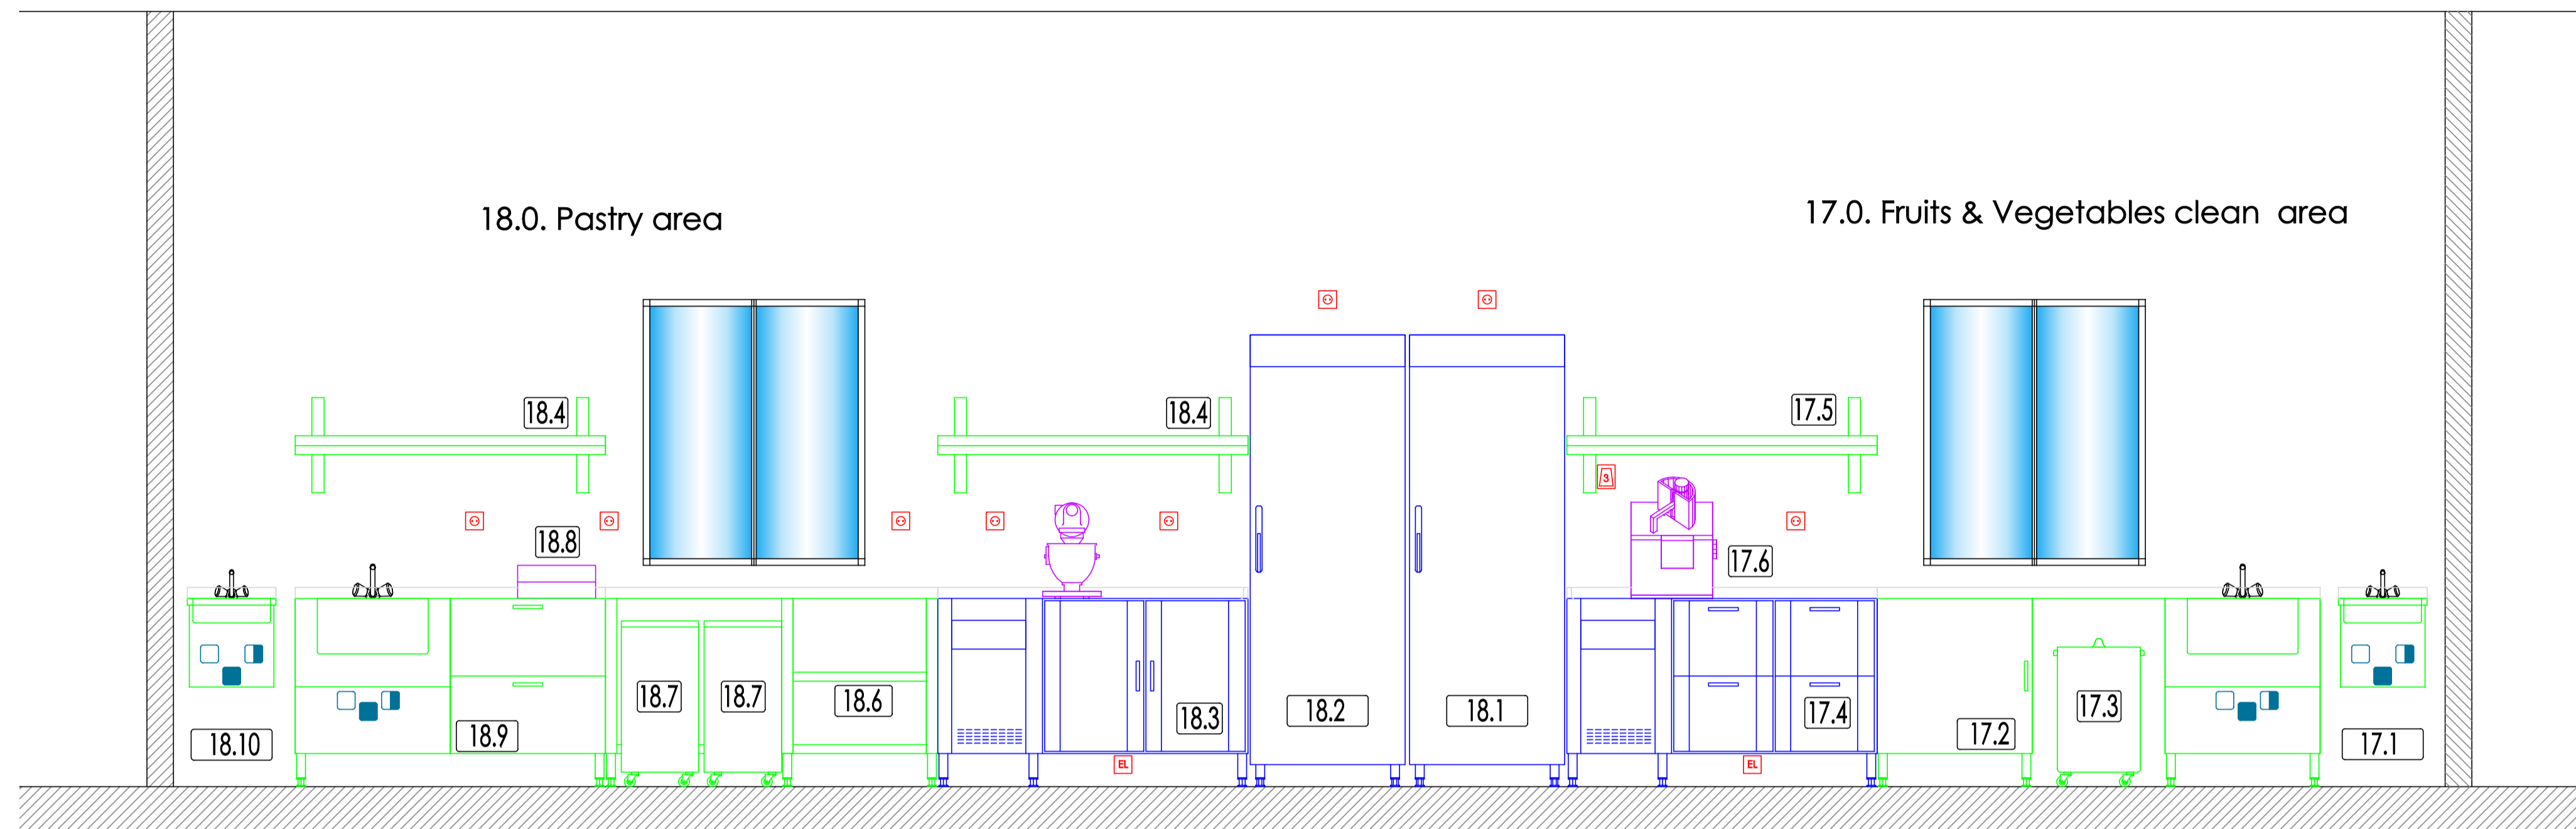

Plan

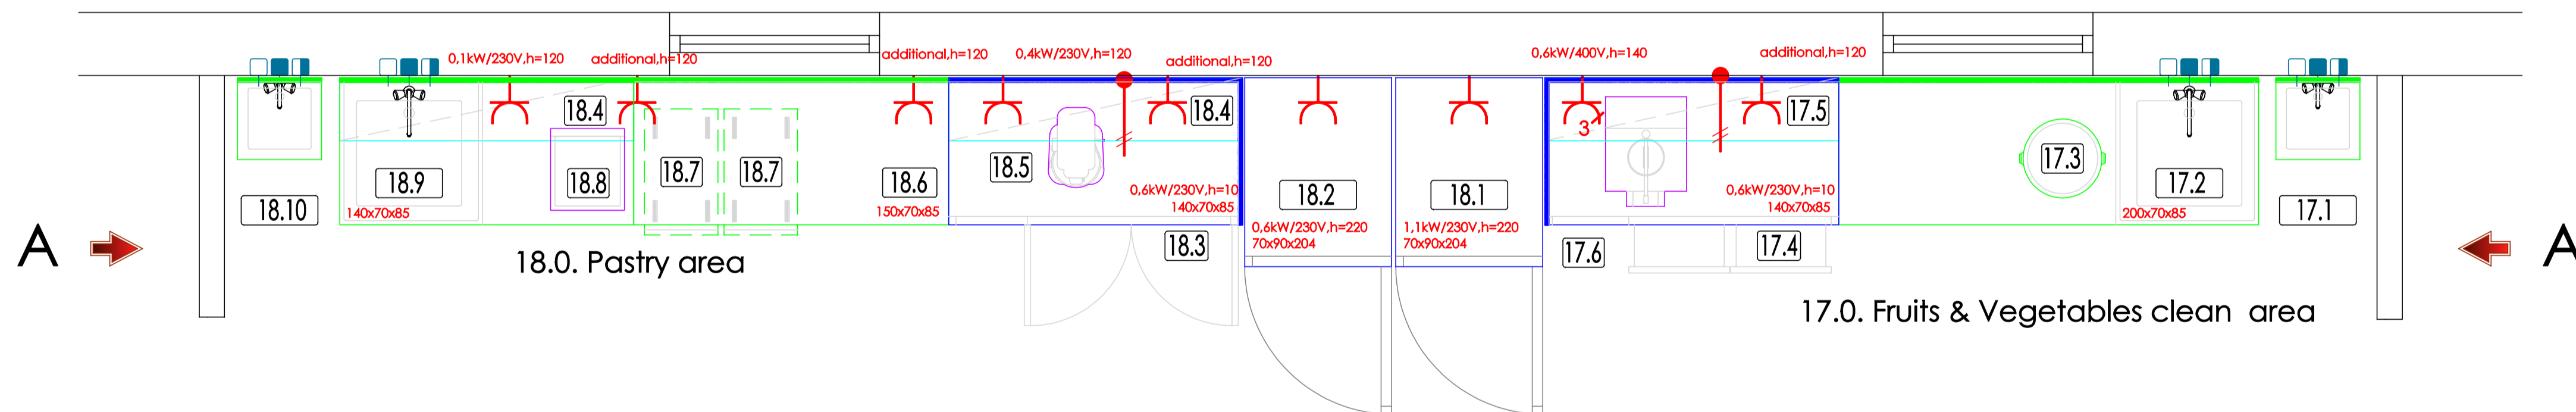

GT.08


Elevations of production lines

Kitchen area

Centrum Hotelowo - Konferencyjne

scale 1:25

Ground Floor

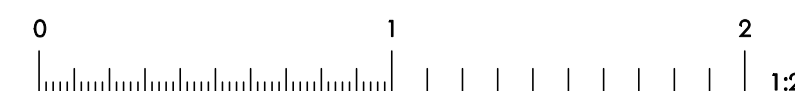

	www.gastro-technologie.pl	LEVEL:	SCALE:
	Biuro Projektowe Kuchni Profesjonalnej ADAM RZĄDKOWSKI	Piaseczno, ul. Strusia 6a/27, 05-500 tel. +48 663-446-224; e-mail: biuro@gastro-technologie.pl	Ground Floor
TOPIC: Kitchen area	CONTENTS: Elevations of production lines	PHASE: As Built	DWG NO: GT_08
ADDRESS: Centrum Hotelowo - Konferencyjne	DESIGNED BY: mgr inż. Adam Rządkowski	BRANCHE: Kitchen Technology	DATE: 05.2010
THE PROJECT IS AN OWNERSHIP OF A COMPANY GASTRO-TECHNOLOGIA AND IS PROTECTED WITH COPYRIGHT			