


- STORAGE AREA [78,06m<sup>2</sup>]
- PREPARATION AREA [41,28m<sup>2</sup>]
- KITCHEN [85,00m<sup>2</sup>]
- SERVERY [40,00m<sup>2</sup>]
- DISHWASHING AREA [32,09m<sup>2</sup>]
- COMMUNICATION [77,32m<sup>2</sup>]
- STAFF AREA [50,92m<sup>2</sup>]
- WASTE, CLEANING [16,60m<sup>2</sup>]
- ROOM OF CONSUMERS 460m<sup>2</sup>]

**GT.01**  
Developing the area

Kitchen area  
Centrum Hotelowo - Konferencyjne

scale 1:50  
Ground Floor

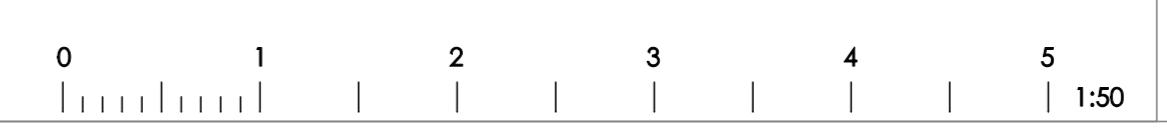

	<a href="http://www.gastro-technologie.pl">www.gastro-technologie.pl</a> Biuro Projektowe Kuchni Profesjonalnej Piaseczno, ul. Strusia 6a/27, 05-500 tel. +48 663-446-224; e-mail: biuro@gastro-technologie.pl	LEVEL: Ground Floor PHASE: As Built BRANCHE: Kitchen Technology	SCALE: 1:50 DWG NO.: GT.01 DATE: 05.2010
	TOPIC: Kitchen area ADDRESS: Centrum Hotelowo - Konferencyjne	CONTENTS: Developing the area DESIGNED BY: mgr inż. Adam Rządkowski	THE PROJECT IS AN OWNERSHIP OF A COMPANY GASTRO-TECHNOLOGIA AND IS PROTECTED WITH COPYRIGHT